LABOR AND MATERIALS

1	Copper / ~~Lead~~ Connection	1 1/2"	$ 12.37
1	Curb Cock / ~~Valve~~ / T.S. & V.	1 1/2 in.	$ 13.45
1	Service box / ~~Old returned~~ Short 3½ x 4½ / ~~Long 4½ x 5½~~ / ~~Buff or Rdway~~		$ 11.20
17	Ft. 1 1/2 in. Copper / ~~G. I.~~ / ~~C. I.~~ Small Pipe at	79	$ 13.43
	Nipples in. at		$
	Bushings to in. at		$
	Red'g / Inc'g Coupl'gs to in. at		$
	Union in. at		$
	Meter in. at		$
	Lead Joints at		$
	Compound Joints at		$
	Maintenance Foreman		$
	Hrs. Water Maint. Man—1 at		$
19	Hrs. Water Maint. Man—2 at	1.24	$ 23.56
12	Hrs. Garage Foreman at	1.59	$ 19.08
48	Hrs. Labor— at	1.13	$ 54.24
	Hrs. Compressor at		$
	Compensation Ins. at $3.861 per C		$ 3.74
	Trucking		$ 1.50
	Pav't Patch		$ 45.36
	Tap by Lareau + Wadleigh		$
	7-20-54		$
			$
	O'head		$
			$197.93

152.57

9688

54

Warren St. ~~Pl.~~ Ave. No. 2-4-6+8

Name of Owner TAX ID# 303.17-16-9

Labor and Mat'l. Report July 20 1954

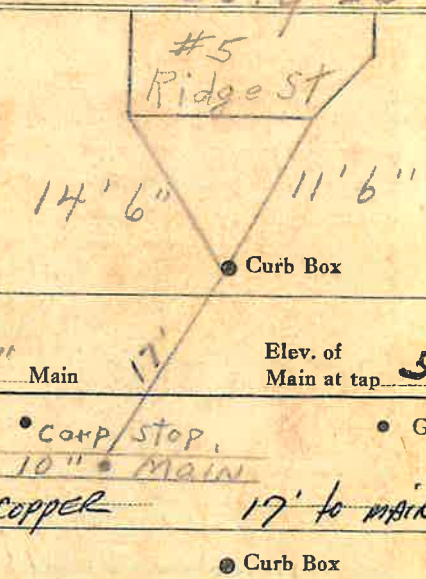

10" Main

Elev. of Main at tap 5"

Gate at • Corp stop. 10" • Main

• Gate at

1 1/2" copper 17' to main

• Curb Box

This Tap feeds stores on Warren + Ridge Sts

Tap on Ridge St.

L&M—5C—2-1-54