LABOR AND MATERIALS

1	Copper / Lead } Connection 3/4	$ 1.31
1	Curb { Cock / Valve / T. S. & V. } 3/4 in.	$ 1.75
1	Service Box Old returned { Short 3½x4½ / Long 4½x5½ / Buff. or Rdway }	$ 1.60
35	Ft. 3/4 in. { Copper / Galv Iron / Cast Iron } Pipe at 18	$ 6.30
	Nipples ____ in. at	$
	Bushings ____ to ____ in. at	$
	Red'g / Inc'g } Couplings ____ to ____ in. at	$
	Union ____ in. at	$
	Meter ____ in. at	$
	Lead Joints at	$
	Leadite Joints at	$
	Hrs. Foreman at	$
9	Hrs. Chauffeur at 62½¢	$ .563
15	Hrs. Tapper at	$ 9.37
20	Hrs. Labor at 45	$ 9.—
	Hrs. Labor at	$
3½	Hrs. Compressor at 62½¢	$ 2.19
	Compensation Ins.	$ .73
	Trucking	$ 1.—
	Builders Use of Water Patch	$ 9.00
		$
		$
		$
		$
		$ 47.78

1 - 1 - 1940

St. 187
~~Pl.~~
Warren ~~Ave.~~ No. 113

Name of Owner TAX ED # 303, 18-19-13

Dimmick

Labor and Mat'l. Report Jan 3 19 40

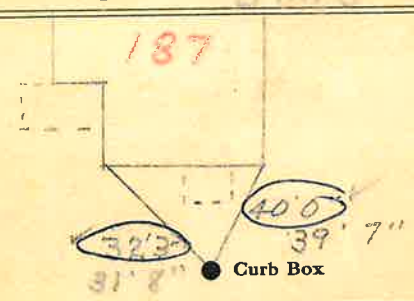

10 Main

Elev. of Main at tap 5½

Gate at ● ● Gate at

3/4" Copper 35' to main

- bent stem ● Curb Box
when turning valve - stop
appear's to be off when on.
" not backward's box"

1

Job Billed