LABOR AND MATERIALS

1	Copper / ~~Lead~~ Connection	3/4	$ 1.23
1	Curb { Cock / ~~Valve~~ / ~~T. S. &~~ V. }	3/4 in.	$ 1.68
	Service Box Old returned { Short 3½x4½ / Long 4½x5½ / Buff. or Rdway }		$ 1.75
12 Ft.	3/4 in. { Copper / Galv Iron / Cast Iron } Pipe at	15	$ 1.80
	Nipples ____ in. at		$
	Bushings ____ to ____ in. at		$
	Red'g / Inc'g Couplings ____ to ____ in. at		$
	Union ____ in. at		$
	Meter ____ in. at		$
	Lead Joints at		$
	Leadite Joints at		$
	Hrs. Foreman at		$
10	Hrs. Chauffeur at	6.25	$ 6.25
	Hrs. Tapper at		$
11	Hrs. Labor at	45	$ 4.95
	Hrs. Labor at		$
1	Hrs. Compressor at	87½	$ .88
	Compensation Ins.		$ .34
	Trucking		$ 1.—
	Builders Use of Water	Patch	$ 9.—
			$
			$
			$
			$
			$ 28.98

0 6 - 1938

St. 138 (238)
Pl.
Ave. Wharton St. No. 140

Name of Owner

Toomey

Labor and Mat'l. Report 8/11-38 **19**

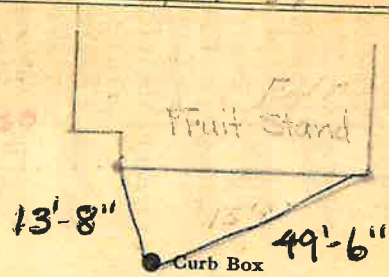

10 Main — Elev. of Main at tap 5'

Gate at ● — ● Gate at

3/4" Copper — 12' to MAIN

● Curb Box

old tap shut off

#230 - #232 TAX ID# 303.18-13-16

to be Billed