LABOR AND MATERIALS

1	Copper Lead — Connection	3/4"	$ 3.20
1	Curb — Cock / Valve / T.S. & V.	3/4 in.	$ 1.25
1	Service box — Old returned — Short 3½ x 4½ / Long 4½ x 5½ / Buff or Rdway		$ 1.30
34	Ft. 3/4 in. — Copper / G.I. / C.I. — Pipe at		$ 7.48
	Nipples in. at		$
	Bushings to in. at		$
1	Red'g / Inc'g — Coupl'gs to 3/4 in. at		$ .15
	Union in. at		$
	Meter in. at		$
	Lead Joints at		$
	Compound Joints at		$
9	Maintenance Foreman	62.5	$ 5.62
6	Hrs. Water Maint. Man—1 at Common Labor	50	$ 3.00
36	Hrs. Water Maint. Man—2 at Common Labor	40 5/6	$ 14.59
	Hrs. Garage Foreman at		$
	Hrs. Labor— at		$
3	Hrs. Compressor at 2 Cylinders		$ 6.00
	Compensation Ins. at $ per C		$ .62
	Trucking		$ 1.00
	Pav't Patch		$
			$
			$
			$
	O'head		$ 43.96

St. Pl. Ave. No. 243 Warren St.

Name of Owner

Chas Coutts

Labor and Mat'l. Report 1957

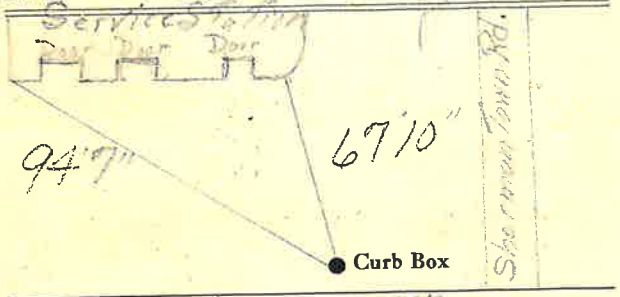

10" Main

Elev. of Main at tap 5'

Gate at ● ● Gate at

3/4" Copper 34' to main

● Curb Box

TAX ID # 310.6-1-26

LSM—5C—2-5 56