## LABOR AND MATERIALS

| | | | |
|---|---|---|---|
| 1 | Copper / ~~Lead~~ Connection | 3/4" | $ 2.96 |
| 1 | Curb — Cock / ~~Valve~~ / ~~T. S. & V.~~ | 3/4 in. | $ 3.49 |
| 1 | Service box Old returned — ~~Short 3½X4½~~ / Long 4½X5½ / ~~Buff or Rdway~~ | 5'x6' | $ 4.74 |
| 18 Ft. | 3/4 in. — Copper / ~~C. I.~~ / ~~C. I.~~ | Pipe at 38 | $ 6.84 |
| | Nipples ... in. at | | $ |
| | Bushings ... to ... in. at | | $ |
| | Red'g Inc'g Coupl'gs ... to ... in. at | | $ |
| | Union ... in. at | | $ |
| | Meter ... in. at | | $ |
| | Lead Joints at | | $ |
| | Compound Joints at | | $ |
| | Hrs. Water Maint. Man—1 at | | $ |
| 2 | Hrs. Water Maint. Man—2 at | 1.24 | $ 2.48 |
| 18 | Hrs. Labor— ... at | 1.13 | $ 20.34 |
| | Hrs. Labor— ... at | | $ |
| | Hrs. Compressor at | | $ |
| | Compensation Ins. at $ 4.406 per C | | $ 1.00 |
| | Trucking | | $ 1.00 |
| | Pav't Patch | | $ 14.40 |
| Tap by Gifford 8-17-53 | | | $ |
| | | | $ |
| | | | $ |
| | O'head | | $ |
| | | | $ 51.05 |

4265

~~St.~~ ~~Pl.~~ Washburn Ave. No. 14

**Name of Owner**

Keegan

**Labor and Mat'l. Report** Aug. 17 1953

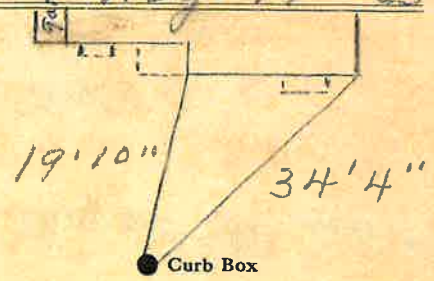


6" Main — Elev. of Main at tap 6'

Gate at ● ● Gate at

3/4" Copper — 18' to main

● Curb Box

TAX ID# 302.20-6-7

LSM-5C 5 15-48