## Labor and Materials

| | | | | |
|---|---|---|---|---|
| 1 | Copper ~~Lead~~ | Connection | 3/4 | $ 1.46 |
| 1 | Curb | Cock ~~Valve~~ T. S. & V. | 3/4 in | $ 1.93 |
| 1 | Service Box Old returned | Short 3½ x 4½ Long ~~4½ x 5½~~ Buff or Rdway | | $ 1.77 |
| 27 27 | Ft. 3/4 in. | Copper ~~Galv Iron~~ ~~Cast Iron~~ | Pipe at | $ 4.81 |
| | Nipples | in. at | | $ |
| | Bushings | to | in. at | $ |
| | Red'g Inc'g | Couplings to | in. at | $ |
| | Union | in. at | | $ |
| | Meter | in. at | | $ |
| | Lead Joints at | | | $ |
| | Leadite Joints at | | | $ |
| | Hrs. Foreman at | | | $ |
| 5 | Hrs. Chauffeur at | | | $ 3.13 |
| 3 | Hrs. Tapper at | | | $ 1.87 |
| 14 | Hrs. Labor at | | | $ 6.30 |
| | Hrs. Labor at | | | $ |
| | Hrs. Compressor at | | | $ |
| | Compensation Ins. | | | $ .35 |
| | Trucking | | | $ 1.— |
| | Builders Use of Water | | | $ |
| | | | | $ |
| | | | | $ |
| | | | | $ |
| | Tap by Penna | | | $ |
| | | | | $ 22.60 |

1 5 0 - 1937

St. E 19
Pl.
Ave. Washington No. 31

Name of Owner TAX ID# 302.20-24-7
Miller Bros

Labor and Mat'l. Report August 1 1937

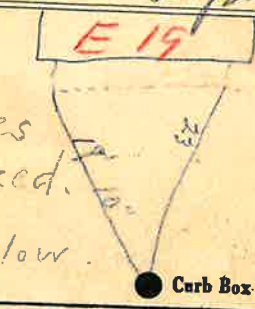


For Empty Lots.

6" Main #19 & 21 Elev. of Main at tap 5'

Gate at 3/4" copper — 27' to MAIN — Gate at

Curb Box N.Y.L.+P. Co. Light Pole base #2189W

25'8" #21 — 20'3" #19

East Washington South Side