Labor and Materials

1	Copper Lead — Connection	3/4	$ 1.46
1	Curb — Cock / Valve / T. S. & V.	3/4 in	$ 1.93
1	Service Box — Old returned — Short 3½ x 4½ / Long 4½ x 5½ / Buff. or Rdway		$ 1.77
21 22	Ft. 3/4 in. — Copper / Galv Iron / Cast Iron — Pipe at		$ 4.84
	Nipples in. at		$
	Bushings to in. at		$
	Red'g Inc's — Couplings to in. at		$
	Union in. at		$
	Meter in. at		$
	Lead Joints at		$
	Leadite Joints at		$
	Hrs. Foreman at		$
5	Hrs. Chauffeur at		$ 3.13
3	Hrs. Tapper at		$ 1.87
14	Hrs. Labor at		$ 6.30
	Hrs. Labor at		$
	Hrs. Compressor at		$
	Compensation Ins.		$ .35
	Trucking		$ 1.—
	Builders Use of Water		$
			$
			$
	Tap by Hand		$
			$ 22.60

1 5 2 - 1937

St. E 21
Pl.
Washington Ave. No. 33

Name of Owner TAX ID# 302.20-24-6
Casavant

Labor and Mat'l. Report Sept 2 19

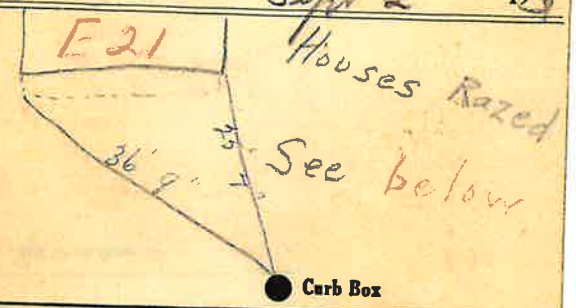

For Empty Lots.

6" Main #19 #21 Elev. of Main at tap 5'

Gate at ● 3/4" copper — 27' to MAW — ● Gate at

● Curb Box

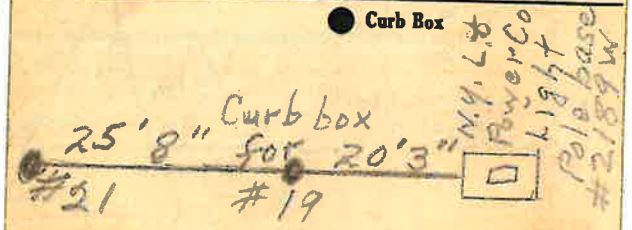

East Washington South Side