Labor and Materials

1	Copper / Lead Connection	3/4	$ 1.46
1	Curb Cock / ~~Valve~~ / ~~T. S. & V.~~	3/4 in	$ 1.93
1	Service Box / ~~Old returned~~ ~~Short 3½ x 4½~~ / Long 4½ x 5½ / ~~Buff. or Rdway~~		$ 1.77
19 ~~10~~	Ft. 3/4 in. Copper / ~~Galv Iron~~ / ~~Cast Iron~~ Pipe at 22		$ 2.20
	Nipples in. at		$
	Bushings to in. at		$
	Red'g / Inc'g Couplings to in. at		$
	Union in. at		$
	Meter in. at		$
	Lead Joints at		$
	Leadite Joints at		$
	Hrs. Foreman at		$
3	Hrs. Chauffeur at 62½		$ 1.88
	Hrs. Tapper at		$
8	Hrs. Labor at .45		$ 3.60
	Hrs. Labor at		$
	Hrs. Compressor at		$
	Compensation Ins.		$ 17
	Trucking		$ 1.00
	Builders Use of Water Patch (Sewer)		$ 2.50
			$
			$
			$
	Tap made by Pinon		$
			$ 16.51

23-1937

St. ~~Pl.~~ Ave. No. 34 E 22

Washington

Name of Owner

Mrs J. Hannum

Labor and Mat'l. Report May 10 1937

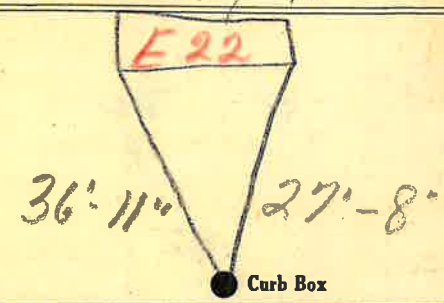

TAX ID # 302.20-18-26

6 Main

Elev. of Main at tap 4

Gate at 3/4" COPPER 19' to MAIN Gate at

Curb Box

New House