Labor and Materials

1 Copper / ~~Lead~~ Connection 3/4 ..... $ 1.46

1 Curb { Cock / Valve / ~~T. S. & V.~~ } 3/4 in ..... $ 1.93

1 Service Box { Short 3½ x 4½ / ~~Long 4½ x 5½~~ / Buff. or Rdway } ..... $ 1.77
Old returned

27 25 Ft. 3/4 in. { Copper / ~~Galv. Iron~~ / ~~Cast Iron~~ } Pipe at ..... $ 5.50

..... Nipples ..... in. at ..... $

..... Bushings ..... to ..... in. at ..... $

..... Red'g / Inc'g { Conplings ..... to ..... in. at ..... $

..... Union ..... in. at ..... $

..... Meter ..... in. at ..... $

..... Lead Joints at ..... $

..... Leadite Joints at ..... $

..... Hrs. Foreman at ..... $

5 ..... Hrs. Chauffeur at ..... $ 2.13

3 ..... Hrs. Tapper at ..... $ 1.80

14 ..... Hrs. Labor at ..... $ 6.30

..... Hrs. Labor at ..... $

..... Hrs. Compressor at ..... $

..... Compensation Ins. ..... $ .35

..... Trucking ..... $ 1.-

..... Builders Use of Water ..... $

..... $

..... $

Tuphy Henes ..... $

$ 23.26

153 - 1937

E 25-

St. Washington Ave. No. 37

Name of Owner

G.F. Hotel Corp.

Labor and Mat'l. Report Sept 2 1937

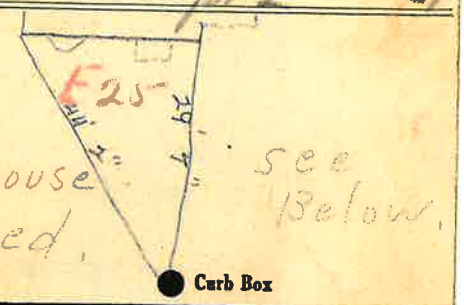

Located & Remeasured 7-22-54

6" Main Elev. of Main at tap 5'

Gate at • • Gate at
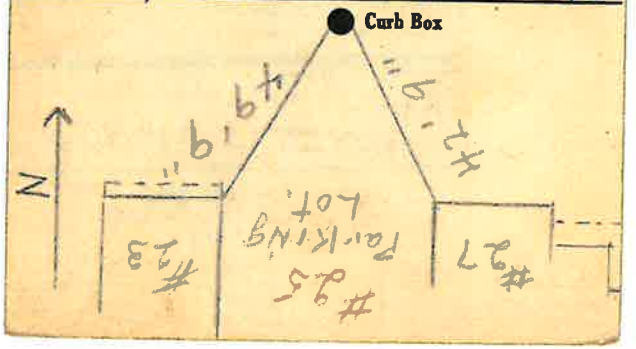
37' to main 3/4" copper