Labor and Materials

1	Copper ~~Lead~~	Connection 3/4	$ 1.46
1	Curb — Cock ~~Valve~~ ~~T. S. & V.~~	3/4 in	$ 1.93
1	Service Box Old returned — Short 3½ x 4½ ~~Long 4½ x 5½~~ ~~Buff. or Rdway~~		$ 1.70
27	Ft. 3/4 in. — Copper ~~Galv Iron~~ ~~Cast Iron~~	Pipe at	$ 5.06
	Nipples	in. at	$
	Bushings	to in. at	$
	Red'g Inc'g	Conplings to in. at	$
	Union	in. at	$
	Meter	in. at	$
	Lead Joints at		$
	Leadite Joints at		$
	Hrs. Foreman at		$
5	Hrs. Chauffeur at		$ 3.13
3	Hrs. Tapper at		$ 1.87
14	Hrs. Labor at		$ 6.30
	Hrs. Labor at		$
	Hrs. Compressor at		$
	Compensation Ins.		$ .35
	Trucking		$ 1.—
	Builders Use of Water		$
			$
			$
			$
	Tap by Mrell		$
			$ 22.82

154-1937

St. ~~Pl.~~ E 27

Washington Ave. No. 39

Name of Owner

Mary Rice

Labor and Mat'l. Report Sept 3 1937

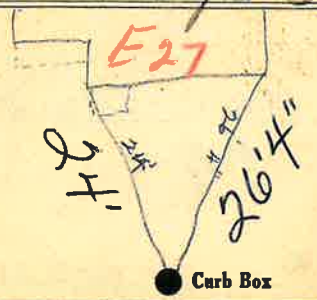

6" Main — Elev. of Main at tap 5"

Gate at 3/4" main — 27' to main Gate at

Curb Box

Old tap disc