Labor and Materials

1	Copper / ~~Lead~~ Connection 3/4	$ 1.46
1	Curb Cock / Valve / T. S. & V. in	$ 1.03
1	Service Box / Old returned ~~Short 3½ x 4½~~ / Long 4½ x 5½ / Buff. or Rdway	$ 1.77
27 / 22	Ft. 3/4 in. Copper / ~~Galv. Iron~~ / ~~Cast Iron~~ Pipe at	$ 5.06
	Nipples in. at	$
	Bushings to in. at	$
	Red'g / Inc'g Conplings to in. at	$
	Union in. at	$
	Meter in. at	$
	Lead Joints at	$
	Leadite Joints at	$
	Hrs. Foreman at	$
5	Hrs. Chauffeur at	$ 3.13
3	Hrs. Tapper at	$ 1.82
14	Hrs. Labor at	$ 6.30
	Hrs. Labor at	$
	Hrs. Compressor at	$
	Compensation Ins.	$ .35
	Trucking	$ 7.[illegible]
	Builders Use of Water	$
		$
		$
		$
	Tap by Hand	$
		$ 22.82

156-1937

St. / Pl. / Ave. Washington No. 41 E29

Name of Owner

Townsend

Labor and Mat'l. Report Sept. 1937

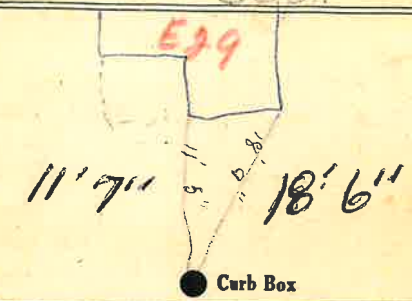

6 Main

Elev. of Main at tap 5

Gate at 3/4" COPPER

Gate at 27' to MAIN

Curb Box

Old tap disc

[illegible]