## Labor and Materials

| | | | |
|---|---|---|---|
| 1 | Copper ~~Lead~~ | Connection 3/4 | $ 1.46 |
| 1 | Curb | Cock ~~Valve~~ ~~T. S. & V.~~ 3/4 in | $ 1.93 |
| 1 | Service Box ~~Old returned~~ | ~~Short 3½ x 4½~~ Long 4½ x 5½ ~~Buff. or Rdway~~ | $ 1.77 |
| 27 ~~22~~ | Ft. 3/4 in. | Copper ~~Galv. Iron~~ ~~Cast Iron~~ Pipe at 3/4 | $ 4.84 |
| | Nipples | in. at | $ |
| | Bushings | to in. at | $ |
| | Red'g Inc'g | Couplings to in. at | $ |
| | Union | in. at | $ |
| | Meter | in. at | $ |
| | Lead Joints at | | $ |
| | Leadite Joints at | | $ |
| | Hrs. Foreman at | | $ |
| 5 | Hrs. Chauffeur at | | $ 3.13 |
| 3 | Hrs. Tapper at | | $ 1.82 |
| 14 | Hrs. Labor at | | $ 6.30 |
| | Hrs. Labor at | | $ |
| | Hrs. Compressor at | | $ |
| | Compensation Ins. | | $ .35 |
| | Trucking | | $ 1.– |
| | Builders Use of Water | | $ |
| | | | $ |
| | | | $ |
| | | | $ |
| | Tap by Owner | | $ |
| | | | $ 22.60 |

45-1937

St. ~~Pl.~~ ~~Ave.~~ E 11 No. 23

Washington

Name of Owner TAX ID # 302.20-24-11

Kennedy

Labor and Mat'l. Report Aug 31 1937

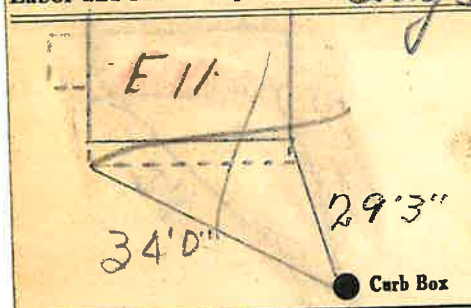


6 Main

Elev. of Main at tap 5

Gate at Insidewalk

Gate at

Curb Box

3/4" copper

65'-8"

Curb Box Fot #11 E. Washington

1st National Bank Bldg #13 E. Wash

27' to main