Labor and Materials

1	Copper ~~Lead~~	Connection	3/4	$ 1.46
1	Curb	Cock ~~Valve~~ ~~T. S. & V.~~	3/4 in	$ 1.93
1	Service Box	~~Short 3½ x 4½~~ Long 4½ x 5½ ~~Buff. or Rdway~~		$ 1.77
19	Old returned			
~~10~~	Ft. 3/4 in.	Copper ~~Galv Iron~~ ~~Cast Iron~~	Pipe at	$ 2.28
	Nipples	in. at		$
	Bushings	to in. at		$
	Red'g Inc'g	Couplings to in. at		$
	Union	in. at		$
	Meter	in. at		$
	Lead Joints at			$
	Leadite Joints at			$
	Hrs. Foreman at			$
2½	Hrs. Chauffeur at			$ 1.57
1½	Hrs. Tapper at			$ .94
6½	Hrs. Labor at			$ 2.93
	Hrs. Labor at			$
	Hrs. Compressor at			$
	Compensation Ins.			$ .17
	Trucking			$ 1.—
	Builders Use of Water			$
				$
				$
				$
Typed by Hand				$
				$ 13.85

148-1937

St. E 12
Pl.—
Washington Ave. No. 26

Name of Owner
Galusha

Labor and Mat'l. Report Aug 31 1937

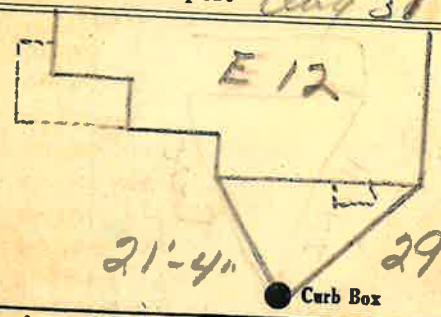

TAX ID # 302.20-18-22

½ Main Elev. of Main at tap 5

Gate at ● 3/4" Copper 19' to MAIN ● Gate at

● Curb Box

Old tap closed

AV