Labor and Materials

1	Copper Lead — Connection	3/4	$ 1.16
1	Curb — Cock / ~~Valve~~ / T. S. & V.	3/4 in	$ 1.03
1	Service Box — Old returned — Short ~~2½ x 4½~~ / Long 4½ x 5½ / Buff. or Rdwax		$ 1.77
19 ~~10~~	Ft. 3/4 in. — Copper / ~~Galv Iron~~ / Cast Iron — Pipe at		$ 7.70
	Nipples	in. at	$
	Bushings	to in. at	$
	Red'g / Inc'g — Couplings	to in. at	$
	Union	in. at	$
	Meter	in. at	$
	Lead Joints at		$
	Leadite Joints at		$
	Hrs. Foreman at		$
2½	Hrs. Chauffeur at		$ 1.57
1½	Hrs. Tapper at		$ .94
6½	Hrs. Labor at		$ 2.03
	Hrs. Labor at		$
	Hrs. Compressor at		$
	Compensation Ins.		$ .17
	Trucking		$ 1.-
	Builders Use of Water		$
			$
			$
	Tapping Sleeve		$
			$ 13.97

1 4 9- 1937

St. E 18
Pl.
Washington Ave. No. 30

Name of Owner
Hannan

Labor and Mat'l. Report Sept 1 1937

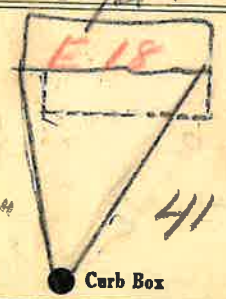

TAX ID# 302.20-18-24

1 Main — Elev. of Main at tap 5

Gate at 3/4" copper — Gate at 19' to main

Curb Box

Seal tap also