LABOR AND MATERIALS

1	Copper ~~Lead~~ Connection	3/4	$ 1.31
1	Curb { Cock / ~~Valve~~ / ~~T. S. & V.~~ }	3/4 in.	$ 1.75
1	Service Box Old returned { ~~Short 3½x4½~~ / Long 4½x5½ / ~~Buff. or Rdway~~ }		$ 1.60
34 Ft.	3/4 in. { Copper / ~~Galv Iron~~ / ~~Cast Iron~~ } Pipe at	18	$ 6.12
	Nipples ____ in. at		$
	Bushings ____ to ____ in. at		$
	Red'g / Inc'g Couplings ____ to ____ in. at		$
	Union ____ in. at		$
	Meter ____ in. at		$
	Lead Joints at		$
	Leadite Joints at		$
	Hrs. Foreman at		$
5	Hrs. Chauffeur at	62½¢	$ 3.12
	Hrs. Tapper at		$
8	Hrs. Labor at	45	$ 3.60
	Hrs. Labor at		$
1	Hrs. Compressor at	62½¢	$ .63
	Compensation Ins.		$ .21
	Trucking		$ 1.—
	Builders Use of Water ½¢ Patch (Sewer)		$ 2.50
	Tap by Person		$
			$
			$
			$
			$ 14.54

8 9 - - 1940

OPP. EDISON RD.

St. ~~Pl.~~ 47

Webster Ave. No. 49

Name of Owner

~~Chase~~ LEHMANN

Labor and Mat'l. Report Aug 24 1940

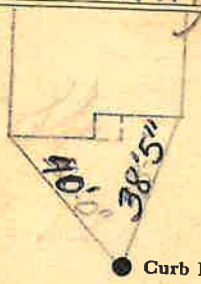

12 Main

Elev. of Main at tap 3

Gate at ●

● Gate at 34' to main

● Curb Box

TAX ID# 302.11-6-3