LABOR AND MATERIALS

1	Copper Lead — Connection	3/4	$ 1.78
1	Curb — Clock / Valve / T. S. & V.	3/4 in.	$ 2.61
1	Service box Old returned — Short 3½X4½ / Long 4½X5½ / Buff or Rdway		$ 1.82
33	Ft. 3/4 in. — Copper / Galv. Iron / Cast Iron — Pipe at 23		$ 7.59
	Nipples ... in. at		$
	Bushings ... to ... in. at		$
	Red'g / Inc'g — Couplings ... to ... in. at		$
	Union ... in. at		$
	Meter ... in. at		$
	Lead Joints at		$
	Compound Joints at		$
	Hrs. Foreman at		$
6	Hrs. Chauffeur at	82½	$ 4.95
1	Hrs. Tapper at		$
6	Hrs. Labor at	71½	$ 4.29
	Hrs. Labor at		$
3	Hrs. Compressor at	.875	$ 2.63
	Compensation Ins.		$ .25
	Trucking		$ 1.00
	Builders Use of Water		$ 5.00
	Tap by Waterworks		$
			$
			$
			$
			$ 31.82

17-46 ✓ 51

~~St.~~ ~~Pl.~~ Webster Ave. No. 49

Name of Owner

Thomas Mendell

Labor and Mat'l. Report Aug 19 19 46

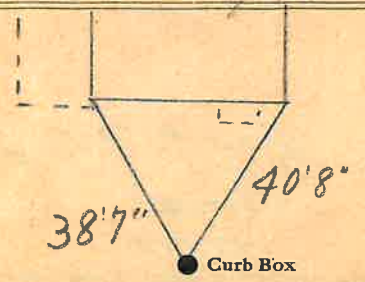

12 Main — Elev. of Main at tap 3'

Gate at ● ● Gate at

33' to main

● Curb Box

TAX ID # 302.11-6-1

LSM-SC-6-1-45