LABOR AND MATERIALS

1 Copper Lead	Connection 3/4	$ 1.35
1 Curb { Cock Valve T. S. & V. }	3/4 in.	$ 1.80
1 Service Box Old returned	{ Short 3⅛x4⅛ Long 4⅛x5⅛ Buff or Rdway }	$ 1.70
32 Ft. 3/4 in.	{ Copper Galv Iron Cast Iron } Pipe at 18	$ 5.76
Nipples	in. at	$
Bushings	to in. at	$
Red'g Inc'g	Couplings to in. at	$
Union	in. at	$
Meter	in. at	$
Lead Joints at		$
Leadite Joints at		$
Hrs. Foreman at		$
3/4 Hrs. Chauffeur at	62½	$ 1.88
8 Hrs. Tapper at		$ 5.00
8 Hrs. Labor at	45	$ 3.60
Hrs. Labor at		$
2 Hrs. Compressor at	62½	$ 1.25
Compensation Ins.		$ .37
Trucking		$ 1.—
Builders Use of Water	½ Patch (Sewer)	$ 2.50
Taply Hassel		$
		$
		$
		$
		$ 26.16

4 6 1941

St. Pl. Webster Ave. No. 65

Name of Owner TAX ID #302.12-17-12
Clink

Labor and Mat'l. Report July 8 19

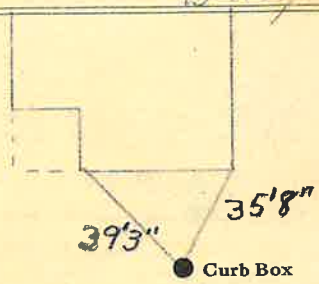

1½ Main

Elev. of Main at tap

Gate at

Gate at

32' to main

Curb Box