LABOR AND MATERIALS

1	Copper / ~~Lead~~ Connection	3/4	$ 2.94
1	Curb { Cock / ~~Valve~~ / ~~T. S. & V.~~ }	3/4 in.	$ 3.71
1	Service box { Short 3½X4½ / Long ~~4½X5½~~ / Buff or Rdway / ~~Old returned~~ }		$ 5.90
32	Ft. 3/4 in. { Copper / ~~G. I.~~ / ~~C. I.~~ } Pipe at 30		$ 9.60
	Nipples ..... in. at		$
	Bushings ..... to ..... in. at		$
	Red'g Inc'g Coupl'gs ..... to ..... in. at		$
	Union ..... in. at		$
	Meter ..... in. at		$
	Lead Joints at		$
	Compound Joints at		$
1/2	Hrs. Water Maint. Man—1 at	1.01	$ .51
5	Hrs. Water Maint. Man—2 at	.91	$ 4.55
21	Hrs. Labor— ....at	.80	$ 16.80 21.86
	Hrs. Labor— ....at		$
3/4	Hrs. Compressor at	1.20	$ .90
	Compensation Ins. at $ ..... per C		$ .48
	Trucking		$ 1.—
	Pav't Patch		$ 20.70
	Tap & Turn		$
			$
			$
	O'head		$
			$ 67.09

6-1/41

~~St.~~
~~Pl.~~
Webster Ave. No. 67

Name of Owner

Jones

Labor and Mat'l. Report July 21 1948

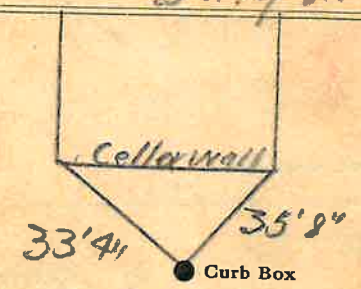

12 Main

Elev. of Main at tap 5

Gate at ● ● Gate at

32' to main

● Curb Box

10/22
not on map

LSM-SC S 15-48