LABOR AND MATERIALS

1	Copper / ~~Lead~~ Connection 3/4	$ 2.87
1	Curb { Cock / ~~Valve~~ / ~~T. S. & V.~~ } 3/4 in.	$ 3.62
1	Service box { ~~Old returned~~ } Short 3½X4½ / Long 4½X5½ / Buff or Rdway	$ 4.68
30 Ft. 3/4 in.	{ Copper / ~~G. I.~~ / ~~C. I.~~ } Pipe at 32	$ 9.60
	Nipples ..... in. at	$
	Bushings ..... to ..... in. at	$
	Red'g / Inc'g Coupl'gs ..... to ..... in. at	$
	Union ..... in. at	$
	Meter ..... in. at	$
	Lead Joints at	$
	Compound Joints at	$
	Hrs. Water Maint. Man—1 at	$
5	Hrs. Water Maint. Man—2 at 1.02	$ 5.10
12	Hrs. Labor— ....at 91	$ 10.92
	Hrs. Labor— ....at	$
4	Hrs. Compressor at 1.20	$ 4.80
	Compensation Ins. at $ 2.18 per C	$ .35
	Trucking	$ 2.00
	Pav't Patch	$ 10.25
Typ. by Warsinske		$
		$
		$
	O'head	$
		$ 54.19

19

~~St.~~ ~~Pl.~~ Webster Ave. No. 69

Name of Owner

Capitol

Labor and Mat'l. Report Cpl 30 19 19

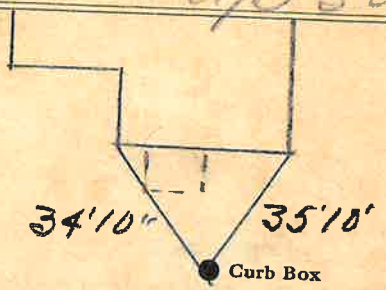

12" Main Elev. of Main at tap 4½

Gate at ● ● Gate at

30' to main

● Curb Box

10/22 not on map

LSM-SC 5 15-48