Webster ~~St.~~ ~~Pl.~~ Ave. No. 96

Name of Owner

TAX ID# 302.12-2-22

Labor and Mat'l. Report Nov 19 88

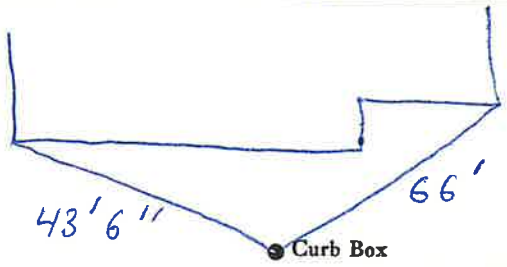

Main Elev. of Main at tap

Gate at ● ● Gate at

14' to MAIN

● Curb Box

LSM—5C—6-1-67

LABOR AND MATERIALS

Copper / Lead } Connection $

Curb { Cock / Valve / T. S. & V. } in. $

Service box / Old returned { Short 3½ x 4½ / Long 4½ x 5½ } $

14 Ft. 1 in. { Copper / ~~G. I.~~ / ~~C. I.~~ } Pipe at $

Nipples in. at $

Bushings to in. at $

Red'g / Inc'g } Coupl'gs to in. at $

Union in. at $

Meter in. at $

$

Compound Joints at $

Maintenance Foreman $

Hrs. Water Maint. Man—1 at $

Hrs. Water Maint. Man—2 at $

Hrs. Garage Foreman at $

Hrs. Labor— at $

Hrs. Compressor at $

$

Trucking $

Pav't Patch $

$

$

$

$

$