LABOR AND MATERIALS

1	Copper Lead } Connection	3/4	$ 1.78
1	Curb { Clock Valve E. S. & V. }	3/4 in.	$ 2.61
1	Service box Old returned { Short 3½X4½ ~~Long 4½X5½~~ Buff or Rdway. }		$ 1.82
13	Ft. 3/4 in. { Copper Galv. Iron Cast Iron } Pipe at 23		$ 2.99
	Nipples in. at		$
	Bushings to in. at		$
	Red'g Inc'g } Couplings to in. at		$
	Union in. at		$
	Meter in. at		$
	Lead Joints at		$
	Compound Joints at		$
2	Hrs. ~~Foreman~~ at WWM	84	$ 1.68
	Hrs. Chauffeur at		$
	Hrs. Tapper at		$
2	Hrs. Labor at	65	$ 1.30
	Hrs. Labor at		$
	Hrs. Compressor at		$
	Compensation Ins.		$ .08
	Trucking		$ 1.00
	Builders Use of Water		$ —
	Tap by Miller		$
			$
			$
			$
			$ 13.26

✓

West 46 Glens Falls.

~~Courtlit~~ St. Pl. Ave. No.

Name of Owner Western Ave. South.

Scoville

Labor and Mat'l. Report June 11 1946

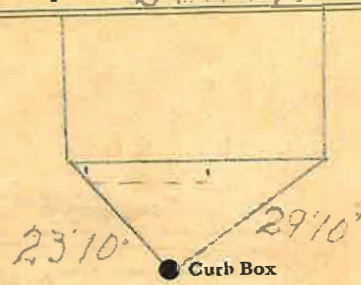

12 Main

Elev. of Main at tap 5

Gate at ●

● Gate at

13' to MAIN

● Curb Box

LSM-5C-6-1-45