LABOR AND MATERIALS

1	Copper / Lead	Connection 3/4		$ 2.87
1	Curb	Cock / Valve / T. S. & V. 3/4 in.		$ 3.62
1	Service box / Old returned	Short 3½X4½ / Long 4½X5½ / Buff or Rdway		$ 4.68
11	Ft. 3/4 in.	Copper / G. I. / C. I.	Pipe at 32	$ 3.52
	Nipples	in. at		$
	Bushings	to in. at		$
	Red'g Inc'g	Coupl'gs to in. at		$
	Union	in. at		$
	Meter	in. at		$
	Lead Joints at			$
	Compound Joints at			$
2	Hrs. Water Maint. Man—1 at		1.12	$ 2.24
	Hrs. Water Maint. Man—2 at			$
2	Hrs. Labor— at		91	$ 1.82
	Hrs. Labor— at			$
	Hrs. Compressor at			$
	Compensation Ins. at $ 2.18 per C			$ .09
	Trucking			$ 2.00
	Pav't Patch			$ —
	Tap by Miller			$
				$
				$
	O'head			$
				$ 20.84

11

W. Glens Falls.

St. Pl. Ave. No. Continue Ave

Name of Owner Western Ave. South, Bateage

Labor and Mat'l. Report Mar 30 1949

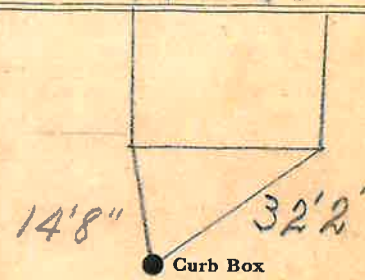

12 Main

Elev. of Main at tap 4½

Gate at ● ● Gate at

11' to MAIN

● Curb Box

LSM-SC 5 15-48