LABOR AND MATERIALS

1	Copper ~~Lead~~ Connection	3/4	$ 2.94
1	Curb { Clock / ~~Valve~~ / ~~T. S. & V.~~ }	3/4 in.	$ 3.71
1	Service box ~~Old returned~~ { ~~Short 3½X4½~~ / Long 4½X5½ / Buff or Rdway }		$ 5.90
20	Ft. 3/4 in. { Copper / ~~Galv. Iron~~ / ~~Cast Iron~~ } Pipe at 30		$ 6.00
	Nipples ... in. at		$
	Bushings ... to ... in. at		$
	Red'g / Inc'g Couplings ... to ... in. at		$
	Union ... in. at		$
	Meter ... in. at		$
	Lead Joints at		$
	Compound Joints at		$
	Hrs. Foreman at		$
1	~~Hrs. Chauffeur~~ at WMM-2	91	$ 91
	Hrs. Tapper at		$
4	Hrs. Labor at	80	$ 3.20 4.11
	Hrs. Labor at		$
	Hrs. Compressor at		$
	Compensation Ins.		$ .09
	Trucking		$ 1.00
	Builders Use of Water		$
			$
			$
			$
			$
			$ 23.75

31

North.

~~St.~~ Western ~~Pl.~~ Ave. No. 15

Name of Owner

Ashley

Labor and Mat'l. Report April 30 1948

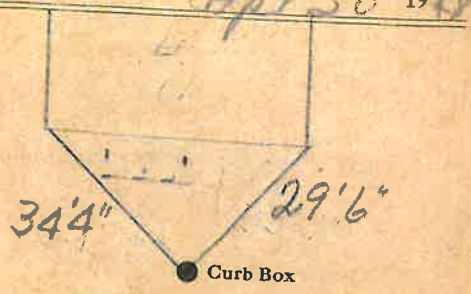

12" Main

Elev. of Main at tap 5

Gate at ●

● Gate at

20' to main

● Curb Box

TAX ID# 302.19-13-17

LSM-5C-6-1-45