LABOR AND MATERIALS

1	Copper / ~~Lead~~ Connection	3/4	$ 1.35
1	Curb { Cock / Valve / T. S. & V. }	3/4 in.	$ 1.80
1	Service Box / Old returned { Short 3½x4½ / Long 4½x5½ / Buff or Rdway }		$ 1.70
37 Ft.	3/4 in. { Copper / Galv Iron / Cast Iron } Pipe at	18	$ 6.66
	Nipples ..... in. at		$
	Bushings ..... to ..... in. at		$
	Red'g / Inc'g { Couplings ..... to ..... in. at		$
	Union ..... in. at		$
	Meter ..... in. at		$
	Lead Joints at		$
	Leadite Joints at		$
	Hrs. Foreman at	62½	$ 1.88
3	Hrs. Chauffeur at	"	$ 5.—
8	Hrs. Tapper at	45	$ 3.60
9	Hrs. Labor at		$
	Hrs. Labor at		$
	Hrs. Compressor at		$ .32
	Compensation Ins.		$
	Trucking		$
	Builders Use of Water ½ Patch (Sewer)		$ 2.50
	Tap by Hassel		$
			$
			$
			$
			$ 25.81

80 1941

~~St.~~ North
~~Pl.~~
Western Ave. No. 16

Name of Owner

~~Hamilton~~ Kippert

Labor and Mat'l. Report Aug 18 1941

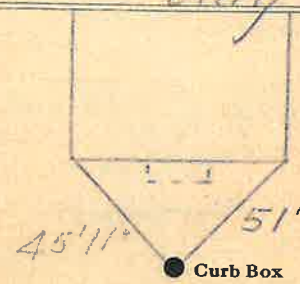

12 Main

Elev. of Main at tap 5—

Gate at ●

● Gate at 37' to main

● Curb Box

TAX ID # 302.19-12-8