LABOR AND MATERIALS

1	Copper Lead	Connection 3/4		$ 2.94
1	Curb	Clock Valve T. S. & V.	3/4 in.	$ 3.71
1	Service box Old returned	Short 3⅛X4⅛ Long 4⅛X5⅛ Buff or Rdway		$ 5.90
15	Ft. 3/4 in.	Copper Galv. Iron Cast Iron	Pipe at 30	$ 6.00
	Nipples	in. at		$
	Bushings	to in. at		$
	Red'g Inc'g	Couplings to in. at		$
	Union	in. at		$
	Meter	in. at		$
	Lead Joints at			$
	Compound Joints at			$
	Hrs. Foreman at			$
1	Hrs. Chauffeur at	WMM-2	91	$ 91
	Hrs. Tapper at			$
4	Hrs. Labor at		80	$ 3.20
	Hrs. Labor at			$
	Hrs. Compressor at			$
	Compensation Ins.			$ .09
	Trucking			$ 1.—
	Builders Use of Water			$
Tap by Maguire				$
				$
				$
				$ 23.75

32 North

Western Ashley

St.
Pl.
Ave. No. 17

Name of Owner

Ashley

Labor and Mat'l. Report April 30 19 47

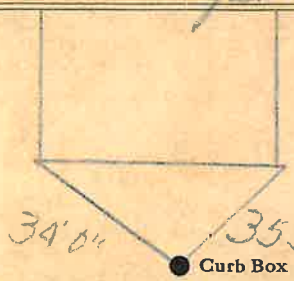

12 Main

Elev. of Main at tap 5

Gate at ● ● Gate at

15' to main

● Curb Box

TAX ID# 302.19-13-16.

LSM-5C-6-1-45