LABOR AND MATERIALS

1	Copper Lead — Connection	3/4	$ 2.94
1	Curb — Clock Valve T. S. & V.	3/4 in.	$ 3.71
1	Service box Old returned — Short 3⅛X4½ / Long 4⅛X5⅛ Buff or Rdway		$ 5.90
14'	Ft. 3/4 in. — Copper / Galv. Iron / Cast Iron	Pipe at 30	$ 4.20
	Nipples ... in. at		$
	Bushings ... to ... in. at		$
	Red'g Inc'g Couplings ... to ... in. at		$
	Union ... in. at		$
	Meter ... in. at		$
	Lead Joints at		$
	Compound Joints at		$
	Hrs. Foreman at		$
2	Hrs. Chauffeur at	91	$ 1.82
5	Hrs. Tapper at		$
5	Hrs. Labor at	80	$ 4.00
	Hrs. Labor at		$
	Hrs. Compressor at		$
	Compensation Ins.		$ .13
	Trucking		$ 1.—
	Builders Use of Water		$
	Tapping Machine		$
1			$
			$
			$
			$ 23.70

30 North St. Pl. Ave. No. 25

Western Ave

Name of Owner

Ashley

Labor and Mat'l. Report Apr 23 1948

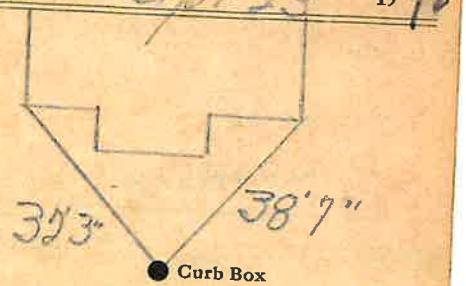

12" Main — Elev. of Main at tap 5'

Gate at ● — ● Gate at

14' to MAIN

● Curb Box

TAX ID # 302.19-13-12

LSM-5C-6-1-45