LABOR AND MATERIALS

1	Copper / ~~Lead~~ Connection	3/4	$ 1.35
1	Curb Cock / Valve / T. S. & V.	3/4 in.	$ 1.80
1	Service Box ~~Old returned~~ Short 3½x4½ / Long 4½x5½ / Buff or Rdway		$ 1.70
15 Ft.	3/4 in. Copper / Galv Iron / Cast Iron Pipe at 18		$ 2.70
	Nipples in. at		$
	Bushings to in. at		$
	Red'g / Inc'g Couplings to in. at		$
	Union in. at		$
	Meter in. at		$
	Lead Joints at		$
	Leadite Joints at		$
	Hrs. Foreman at		$
2	Hrs. Chauffeur at 62½		$ 1.25
	Hrs. Tapper at		$
6	Hrs. Labor at 45		$ 2.70
	Hrs. Labor at		$
	Hrs. Compressor at		$
	Compensation Ins.		$ .12
	Trucking		$ .15
	Builders Use of Water ½ Patch (Sewer)		$ 2.50
	Tap by Miller		$
			$
			$
			$
			$ 15.12

7 8 1941

North

~~St.~~ ~~Pl.~~ Western Ave. No. 27

Name of Owner

G. Iman

Labor and Mat'l. Report Aug 11 19 41

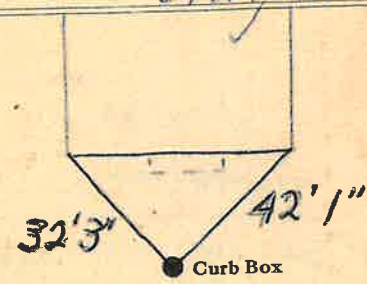

12 Main

Elev. of Main at tap 5

Gate at ●

● Gate at

15' to main

● Curb Box

TAX ID # 302.19-13-11