LABOR AND MATERIALS

1	Copper / ~~Lead~~ Connection	3/4"	$ 1.23
1	Curb { Cock / Valve / T. S. & V. }	3/4 in.	$ 1.68
1	Service Box ~~Old returned~~ { Short 3½x4½ / Long 4½x5½ / Buff. or Rdway }		$ 1.75
11 Ft.	3/4 in. { Copper / ~~Galv Iron~~ / Cast Iron } Pipe at		$ 1.65
	Nipples ____ in. at		$
	Bushings ____ to ____ in. at		$
	Red'g / Inc'g Couplings ____ to ____ in. at		$
	Union ____ in. at		$
	Meter ____ in. at		$
	Lead Joints at		$
	Leadite Joints at		$
	Hrs. Foreman at		$
3	Hrs. Chauffeur at	62½	$ 1.88
	Hrs. Tapper at		$
8	Hrs. Labor at		$ 3.60
	Hrs. Labor at		$
	Hrs. Compressor at		$
	Compensation Ins.		$ .17
	Trucking		$ 1.00
	Builders Use of Water	Patch (Sewer)	$ 2.50
Tap by Person			$
			$
			$
			$
			$ 15.46

1 3 4 - 1938

North
~~St.~~
~~Pl.~~

Western Ave. No. 31

Name of Owner

Gilman

Labor and Mat'l. Report 9-27 1938

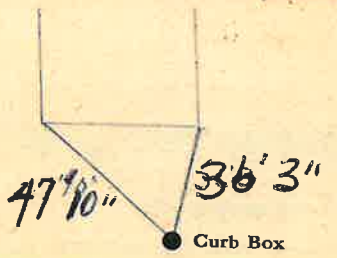

12" Main

Elev. of Main at tap 5'

Gate at ● ● Gate at

11' to main

10/22 - Not on map ● Curb Box

New house.

11