LABOR AND MATERIALS

1	Copper Lead — Connection	3/4	$ 2.87
1	Curb — Cock / Valve / T. S. & V.	3/4 in.	$ 3.62
1	Service box — Old returned — Short 3½X4½ / Long 4½X5½ / Buff or Rdway		$ 4.68
47 Ft. 3 in.	Copper / G. I. / C. I.	Pipe at 3/4 Bell	$ 5.44
30 ft 4	Nipples ..... in. at		$
	Bushings ..... to ..... in. at		$
	Red'g Inc'g — Coupl'gs ..... to ..... in. at		$
	Union ..... in. at		$
	Meter ..... in. at		$
	Lead Joints at		$
	Compound Joints at		$
1	Hrs. Water Maint. Man—1 at 1.17		$ 1.17
1	Hrs. Water Maint. Man—2 at 1.07		$ 1.07
	Hrs. Labor— ....at		$
	Hrs. Labor— ....at		$
	Hrs. Compressor at		$
	Compensation Ins. at $ ..... per C		$ .05
	Trucking		$ 2.02
	Pav't Patch		$
Tap by Miller			$
			$
			$
	O'head		$
			$ 20.80

8

North

St.
Pl.
Ave. No. 54

Western

Name of Owner

Eastman

Labor and Mat'l. Report Dec 21 19 48

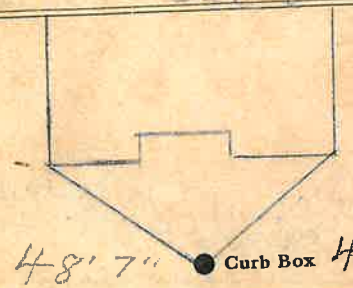

1½ Main

Elev. of Main at tap 3

Gate at ●

● Gate at

47' to main

● Curb Box

10/20 - not on map

LSM-SC 8 15-48