LABOR AND MATERIALS

1	Copper / ~~Lead~~ Connection	3/4"	$ 2.71
1	Curb { Cock / Valve / T. S. & V. }	3/4 in.	$ 3.83
1	Service box { Short 3½ x 4½ / Long 4½ x 5½ / Buff or Rdway } Old returned		$ 4.69
29 Ft.	3/4 in. { Copper / ~~G. I.~~ / ~~C. I.~~ } Pipe at	45	$ 13.05
	Nipples in. at		$
	Bushings to in. at		$
	Red'g / Inc'g Coupl'gs to in. at		$
	Union in. at		$
	Meter in. at		$
	Lead Joints at		$
	Compound Joints at		$
	Maintenance Foreman		$
	Hrs. Water Maint. Man—1 at		$
8	Hrs. Water Maint. Man—2 at	1.24	$ 9.92
	Hrs. Garage Foreman at		$
16	Hrs. Labor— at	1.13	$ 18.08
	Hrs. Compressor at		$
	Compensation Ins. at $ 4.29 per C		$ 1.70
	Trucking		$ 1.50
	Pav't Patch		$ 9.45
Tap by Kissgard 6-6-55			$
			$
			$
	O'head		$
			$ 64.43

Billed 1 ft 2.00

62.43

North

Western St. / Pl. / Ave. No. 8

Name of Owner

Smith

Labor and Mat'l. Report June 6 1955

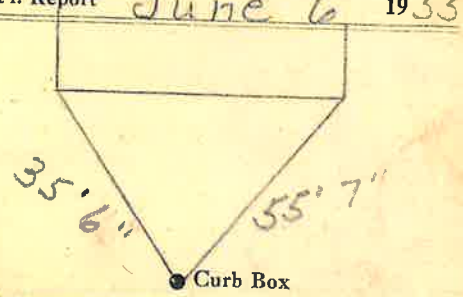

12" Main

Elev. of Main at tap 5"

Gate at ● ● Gate at

29' to main

● Curb Box

TAX ID # 302.19-12-4

L M—5C—2-1-54