LABOR AND MATERIALS

1	Copper / ~~Lead~~ Connection	3/4"	$ 3.04
1	Curb — Cock / ~~Valve~~ / ~~T.S. & V.~~	3/4 in.	$ 3.54
	Service box Old returned — ~~Short 3½x4½~~ / Long 4½x5½ / ~~Buff or Rdway~~		$ 4.70
38 Ft. (13 Ft Billed)	3/4" in. — Copper / ~~G.I.~~ / ~~C.I.~~ Pipe at 35		$ 8.75
	Nipples	in. at	$
	Bushings	to in. at	$
	Red'g / Inc'g Coupl'gs	to in. at	$
	Union	in. at	$
	Meter	in. at	$
	Lead Joints at		$
	Compound Joints at		$
	Hrs. Water Maint. Man—1 at		$
3	Hrs. Water Maint. Man—2 at	1.13	$ 3.39
2	Hrs. Labor— at	1.02	$ 2.04
	Hrs. Labor— at		$
	Hrs. Compressor at		$
	Compensation Ins. at $ per C.		$ .14
	Trucking		$ 1.—
	Pav't Patch outside		$
			$
			$
			$
	O'head		$
			$ 26.60

5.20

Tap made by Gifford
Sept 12 - 1951

1949-1951

North

Western — ~~St.~~ / ~~Pl.~~ Ave. No. 12

Name of Owner

H. W. Freeman

Labor and Mat'l. Report Sept 12 1951

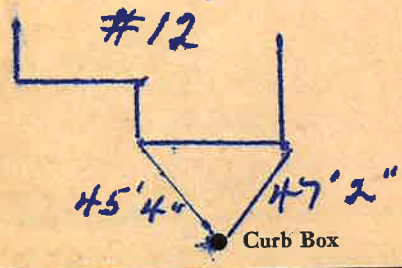

12" Main — Elev. of Main at tap 4'

Gate at ● — ● Gate at 38' to main

● Curb Box

TAX ID# 302.19-12-6

LSM-5C 10-21-49