Labor and Materials

1	Lead Connection 3/4	$
1	Curb Cock 1"	$
1	Service Box Old returned { Short 3½ x 4½ / Long 4½ x 5½ / Buffalo	$
20	Ft. 1" in. G. I. Pipe at	$
	Nipples in. at	$
1	Bushings 1/2 to 1" in. at	$
	Red'g Coup to in. at	$
	Inc'g Coup to in. at	$
	Union in. at	$
	Meter in. at	$
	Cu. Yds. Br. Stone at	$
	Cu. Yds. Sand at	$
	Bags Cement at	$
	Paving Brick { Mack / Red / Asphalt } at	$
4	Hrs. Foreman at	$
12	Hrs. Common Labor at	$
	Hrs. Mason at	$
	Hrs. at	$
	Hrs. at	$
Inv	Builders' Use of Water	$
	at	$
Trucks 100	at	$
	at	$
	at	$
	Total	$ 16.55

15

Labor and Material Report W.E. Sept 22 1973

3/4 Tap Ren #9 William St F-24

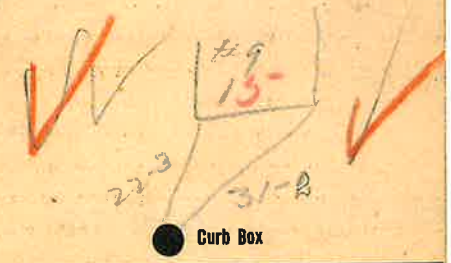

4 Main

Elev. of Main at tap 4½

Gate at ● ● Gate at

1" G.I. 20' to MAIN

● Curb Box

TAX ID# 302.16-17-19