Labor and Materials

1	Lead Connection ¾	$
1	Curb Cock ¾	$
1	Service Box (Short 3½ x 4½ / Long 4½ x 5½ / Buffalo) Old returned	$
12	Ft. ¾ in. G. I. Pipe at	$
	Nipples in. at	$
1	Bushings ¾ to ¾ in. at	$
	Red'g Coup to in. at	$
	Inc'g Coup to in. at	$
	Union in. at	$
	Meter in. at	$
	Cu. Yds. Br. Stone at	$
	Cu. Yds. Sand at	$
	Bags Cement at	$
	Paving Brick (Mack / Red / Asphalt) at	$
3	Hrs. Foreman at	$
8	Hrs. Common Labor at	$
	Hrs. Mason at	$
	Hrs. at	$
	Hrs. at	$
Inc	Builders' Use of Water	$
	at	$
Truck C.O.D.	at	$
	at	$
	at	$
	Total	$ 10.71

Labor and Material Report

Work Done 1973

38

¾" Tap Renewal 38 Williams St

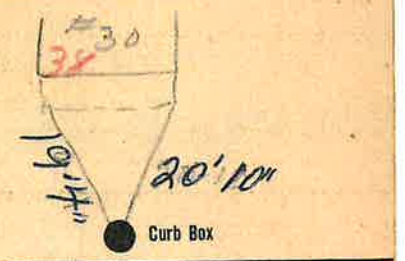

1" Main

Elev. of Main at tap 4½'

Gate at ● ¾" GI 12' to MAIN ● Gate at

● Curb Box

TAX ID # 302.16-15-44