Labor and Materials

1	Lead Connection 1/2	$
1	Curb Cock 3/4	$
1	Service Box Old returned { Short 3½ x 4½ / Long 4½ x 5½ / Buffalo	$
20	Ft. 3/4 in. G. I. Pipe at	$
	Nipples in. at	$
	Bushings to in. at	$
	Red'g Coup to in. at	$
	Inc'g Coup to in. at	$
	Union in. at	$
	Meter in. at	$
	Cu. Yds. Br. Stone at	$
	Cu. Yds. Sand at	$
	Bags Cement at	$
	Paving Brick { Mack / Red / Asphalt } at	$
3	Hrs. Foreman at	$
10	Hrs. Common Labor at	$
	Hrs. Mason at	$
	Hrs. at	$
	Hrs. at	$
no	Builders' Use of Water	$
	Truck at	$
	at	$
	at	$
	at	$
	Total	$ 13.73

Labor and Material Report Week Sept 22 1923

Lot Tap No 39 Williams ST

47.?

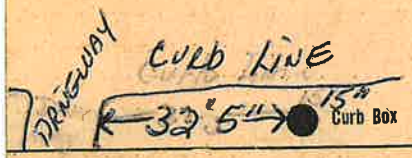

4" Main

Elev. of Main at tap 3½"

Gate at 3/4 GI

Gate at 20' to MAIN

Curb Box

10/22 - not on map