Labor and Materials

1	Copper ~~Lead~~ Connection	3/4	$ 1.46
1	Curb Cock ~~Valve~~ ~~T. S. & V.~~	in 3/4	$ 1.93
1	Service Box Old returned ~~Short 3½ x 4½~~ Long 4½ x 5½ ~~Buff. or Rdway~~		$ 1.77
29	Ft. ..... in. Copper ~~Galv. Iron~~ ~~Cast Iron~~ Pipe at	3/4	$ 6.38
	Nipples ..... in. at		$
	Bushings ..... to ..... in. at		$
	Red'g Inc'g Couplings ..... to ..... in. at		$
	Union ..... in. at		$
	Meter ..... in. at		$
	Lead Joints at		$
	Leadite Joints at		$
	Hrs. Foreman at		$
5	Hrs. Chauffeur at 62½		$ 3.13
	Hrs. Tapper at		$
16	Hrs. Labor at 45		$ 7.20
	Hrs. Labor at		$
	Hrs. Compressor at		$
	Compensation Ins.		$ .32
	Trucking		$ 1.00
	Builders Use of Water		$ 5.00
	Tap made by Larson		$
			$
			$
			$
			$ 28.19

1-5-1937

Way St. ~~Pl.~~ ~~Ave.~~ No. 14

Name of Owner

John Maxson

Labor and Mat'l. Report Apr 27 193?

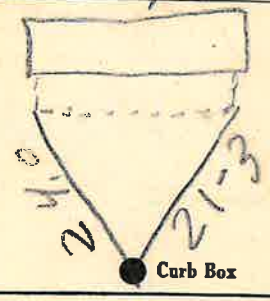

4 Main

Elev. of Main at tap 5'

Gate at ● ● Gate at

29' to main

● Curb Box

TAX ID# 303.13-1-7

old Tap shut off at Main