Labor and Materials

1	Copper ~~Lead~~	Connection	$ 1.48
1	Curb { Cock ~~Valve~~ ~~T.S.&V.~~ }	in	$ 1.79
1	Service Box Old returned { ~~Short 3½x4½~~ Long 4½x5½ ~~Buff. or Redwood~~ }		$ 1.30
8	Ft. in. { Copper ~~Galv. Iron~~ ~~Cast Iron~~ }	Pipe at	$ 1.44
	Nipples	in. at	$
	Bushings	to in. at	$
	Red'g Inc'g	Couplings to in. at	$
	Union	in. at	$
	Meter	in. at	$
	Lbs. Br. Stone at		$
	Lbs. Sand at		$
	Bags Cement at		$
	Paving Brick { Mack Red Asphalt }	at	$
	Lead Joints at		$
	Leadite Joints at		$
2	Hrs. Foreman at		$ 1.25
6	Hrs. Common Labor at		$ 2.70
	Hrs. Common Labor at		$
	Hrs. Mason at		$
	Hrs. Masons Helper at		$
	Hrs. Compressor at		$
	Compensation Ins		$ .12
	Trucking		$ 1.—
	Builders Use of Water Patch		$ .5—

Total $ 14.08

5 32-43

Labor and Material Report May 11 1932

15 Hwy 2 1

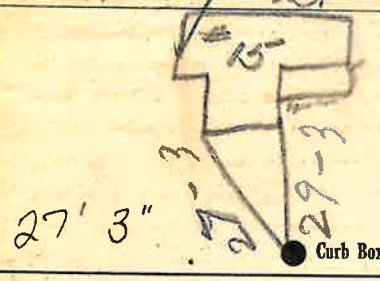

4 Main — Elev. of Main at tap 6

Gate at ● — 8' to MAIN — ● Gate at

● Curb Box

TAX ID# 303.13-2-13

OK. JM