Labor and Materials

1	Copper / ~~Lead~~ Connection	$ 1.50
1	Curb — Cock / ~~Meire~~ / ~~T.S.&V.~~ — in	$ 1.70
1	Service Box — Old returned — Short 3½x4½ / Long 4½x5½ / Buff. or Rdwey	$ 1.50
4	Ft. ... in. — Copper / Galv. Iron / Cast Iron — Pipe at	$ 1.71
	Nipples ... in. at	$
	Bushings ... to ... in. at	$
	Red'g / Inc'g — Couplings ... to ... in. at	$
	Union ... in. at	$
	Meter ... in. at	$
	Lbs. Br. Stone at	$
	Lbs. Sand at	$
	Bags Cement at	$
	Paving Brick — Mack / Red / Asphalt — at	$
	Lead Joints at	$
	Leadite Joints at	$
1	Hrs. Foreman at 6.75	$ 3.75
4	Hrs. Common Labor at 5.0	$ 7.—
	Hrs. Common Labor at	$
	Hrs. Mason at	$
	Hrs. Masons Helper at	$
	Hrs. Compressor at	$
	Compensation Ins	$ 2.21
	Trucking	$ 1.—
	Builders Use of Water Pave. Patch	$ .5—

Total $ 18.41

21 34

Labor and Material Report May 18 19 34

25 Wing St

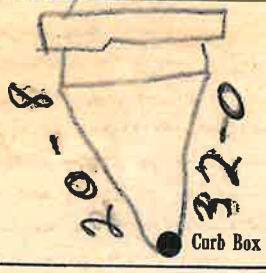

4 Main

Elev. of Main at tap 5[illegible]

Gate at ● ● Gate at 4" to main

● Curb Box

old Tap Shut off Main

~~Syphon~~

TAX ID# 303.9-13-5

M