LABOR AND MATERIALS

1 Copper / Lead	Connection 3/4	$ 1.31
1 Curb	Cock / ~~Valve~~ / ~~T. S. & V.~~ 3/4 in.	$ 1.75
Service Box Old ~~returned~~	Short 3½x4½ / Long 4½x5½ / Buff. or Rdway	$ 1.60
29 Ft. 3/4 in.	Copper / ~~Galv Iron~~ / ~~Cast Iron~~ Pipe at 18	$ 5.22
Nipples	in. at	$
Bushings	to in. at	$
Red'g / Inc'g	Couplings to in. at	$
Union	in. at	$
Meter	in. at	$
Lead Joints at		$
Leadite Joints at		$
Hrs. Foreman at		$
2 Hrs. Chauffeur at	6x½	$ 1.25
8 Hrs. Tapper at		$ 5.00
8 Hrs. Labor at	45	$ 3.60
Hrs. Labor at		$
Hrs. Compressor at		$
Compensation Ins.		$ .30
Trucking		$ 1.—
Builders Use of Water	Patch	$ 5.—
Tap by Hessel		$
		$
		$
		$
		$ 26.03

1 - - 1940

Wing St. ~~Pl.~~ ~~Ave.~~ No. 4

Name of Owner

Alexander

Labor and Mat'l. Report July 8 1940

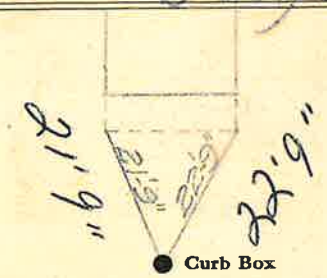

Curb Box

4 Main

Elev. of Main at tap 5—

Gate at

Gate at

29' to MAIN

Curb Box

TAX ID# 303.13-1-2