LABOR AND MATERIALS

1	Copper / ~~Lead~~ Connection	3/4	$ 2.94
1	Curb — Cock / Valve / ~~T. S. & V.~~	3/4 in.	$ 3.71
1	Service box — Short 3½X4½ / Long ~~4½X5½~~ / Buff or Rdway / Old returned		$ 5.90
28 Ft. 3/4 in.	Copper / ~~G. I.~~ / ~~C. I.~~	Pipe at 30	$ 8.40
	Nipples in. at		$
	Bushings to in. at		$
	Red'g Inc'g — Coupl'gs to in. at		$
	Union in. at		$
	Meter in. at		$
	Lead Joints at		$
	Compound Joints at		$
	Hrs. Water Maint. Man—1 at		$
3	Hrs. Water Maint. Man—2 at	9.1	$ 2.73
6	Hrs. Labor— at	80	$ 4.90
	Hrs. Labor— at		$
	Hrs. Compressor at		$
	Compensation Ins. at $ per C		$ 17
	Trucking		$ 1.00
	Pav't Patch		$ 18.70
	Top by Magnuson		$
			$
			$
	O'head		$
			$ 49.35

65

St. Wing Pl. Ave. No. 6

Name of Owner

Ramsey

Labor and Mat'l. Report January 194

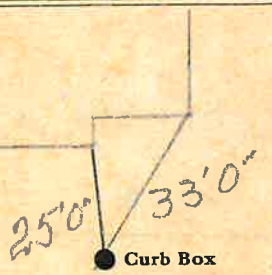

4 Main

Elev. of Main at tap 5

Gate at ● ● Gate at

28' to main

● Curb Box

TAX ID# 303.13-1-3

LSM-5C 5 15-48