LABOR AND MATERIALS

1	Copper / Lead Connection 3/4		$ 2.80
1	Curb Clock / Valve / T. S. & V. 3/4 in.		$ 3.60
1	Service box / Old returned Short 3½X4½ / ~~Long 4½X5½~~ / ~~Buff or Rdway~~		$ 5.80
22	Ft. 3/4 in. Copper / Galv. Iron / Cast Iron Pipe at 35		$ 7.70
	Nipples in. at		$
	Bushings to in. at		$
	Red'g / Inc'g Couplings to in. at		$
	Union in. at		$
	Meter in. at		$
	Lead Joints at		$
	Compound Joints at		$
	Hrs. Foreman at		$
8	Hrs. Chauffeur at	91	$ 7.28
	Hrs. Tapper at		$
5	Hrs. Labor at	80	$ 4.00
	Hrs. Labor at		$
	Hrs. Compressor at		$
	Compensation Ins.		$ .25
	Trucking		$ 1.—
	Builders Use of Water		$ 5.80
	Typ. Worsinski		$
			$
			$
			$
			$ 38.23

51-47

Woodward St. ~~Pl.~~ ~~Ave.~~ No. 11

Name of Owner

Gardiner

Labor and Mat'l. Report July 22 1947

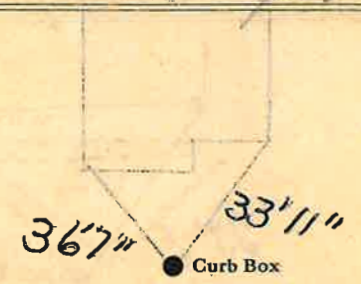

6 Main

Elev. of Main at tap 5—

Gate at ● ● Gate at

22' to main

● Curb Box

TAX ID # 309.16-2-11

LSM-5C-6-1-45