LABOR AND MATERIALS

Copper / Lead } Connection ____ $____

Curb { Cock / Valve / T. S. & V. } ____ in. ____ $____

Service box / Old returned { Short 3½ x 4½ / Long 4½ x 5½ / Buff or Rdway } ____ $____

10 Ft. ____ in. { Copper / ~~G. I.~~ / ~~C. I.~~ } Pipe at ____ $____

____ Nipples ____ in. at ____ $____

____ Bushings ____ to ____ in. at ____ $____

Red'g / Inc'g } Coupl'gs ____ to ____ in. at ____ $____

____ Union ____ in. at ____ $____

____ Meter ____ in. at ____ $____

____ Lead Joints at ____ $____

____ Compound Joints at ____ $____

____ Maintenance Foreman ____ $____

____ Hrs. Water Maint. Man—1 at ____ $____

____ Hrs. Water Maint. Man—2 at ____ $____

____ Hrs. Garage Foreman ____ at ____ $____

____ Hrs. Labor— ____ at ____ $____

____ Hrs. Compressor at ____ $____

____ Compensation Ins. at $____ per C ____ $____

____ Trucking ____ $____

____ Pav't Patch ____ $____

____ $____

____ $____

____ $____

____ O'head ____ $____

$____

Woodard St. / ~~Pl.~~ / Ave. No. 16

Name of Owner

Fred Ford

Labor and Mat'l. Report MAY 5 1931

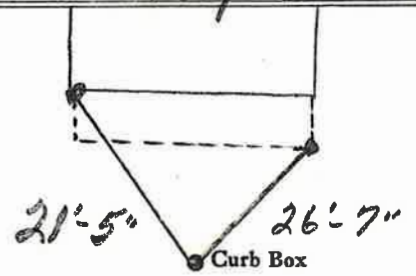

6" Main

Elev. of Main at tap ____

Gate at ●

● Gate at

10' to MAIN

● Curb Box

TAXID # 309.16-5-11

LSM—5C—6-1-67