Labor and Materials

1	Copper / ~~Lead~~ Connection 3/4	$ 1.46
1	Curb: Cock / ~~Valve~~ / ~~T. S. & V.~~ 3/4 in	$ 1.93
1	Service Box ~~Old returned~~: Short 3½ x 4½ / Long ~~4½ x 5½~~ / Buff. or Rdway	$ 1.77
21	Ft. 3/4 in. Copper / ~~Galv. Iron~~ / ~~Cast Iron~~ Pipe at	$ 4.62
	Nipples in. at	$
	Bushings to in. at	$
	Red'g / Inc'g Conplings to in. at	$
	Union in. at	$
	Meter in. at	$
	Lead Joints at	$
	Leadite Joints at	$
	Hrs. Foreman at	$
3	Hrs. Chauffeur at 62½	$ 1.88
	Hrs. Tapper at	$
16	Hrs. Labor at	$ 7.20 / 4.00
	Hrs. Labor at	$
	Hrs. Compressor at	$
	Compensation Ins.	$ .28
	Trucking	$ 1.00
	Builders Use of Water	$ 5.00
		$
		$
Tap made by owner		$
		$ 25.14

2 1 - 1937

Woodlawn ~~St.~~ ~~Pl.~~ Ave. No. 5 9

Name of Owner

Lawrence

Labor and Mat'l. Report May 7 1937

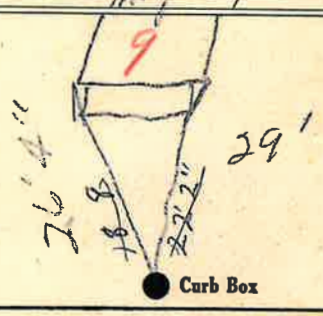

4" Main

Elev. of Main at tap 4½

Gate at ●

● Gate at

21' to MAIN

● Curb Box

Old tap shut off

TAX ID # 309.12-11-31